

**Rocky Mountain  
Remediation Services, L.L.C.**  
*...protecting the environment*



000063493

**INTEROFFICE  
MEMORANDUM**

DATE: September 13, 1996 MAL - MP-DD-011  
TO: S. M. Nesta, NEPA, T130C, X7838  
FROM: D. R. Mittlestadt, Project Management, T130F, X2084  
SUBJECT: REQUEST NEPA REVIEW OF THE REMOVAL AND DEMOLITION OF GUARDPOSTS #461 AND #446 - DRM-003-96  
Action: Provide a NEPA review within project schedule.

**PURPOSE**

The purpose of the memorandum is to request a NEPA review.

**DISCUSSION**

K-H has requested RMRS to provide the removal and demolition of Guardposts #461 and #446, in order to meet one of their performance measures by September 30, 1996.

Guardposts #461 and #446 are two small structures (used as interior guardposts), but are no longer required to support the current mission at Rocky Flats Environments Technology Site (RFETS). The removal of these buildings will involve the following tasks:

- Utilities system isolation, disconnection, and removal.
  - Electrical
  - Water and Sewer
  - Alarms and Security
- Demolition of the building structures using bulldozer and front-end loader.  
(leaving slab on grade)
- Dismantlement and removal of adjacent gate operators.

The existing building materials have been tested for asbestos and the presence of lead in the painted surfaces. Paint waste containing 5ppm of lead or less and non-friable asbestos are acceptable wastes at RFETS landfill. Demolition waste, such as concrete, masonry, and roofing rubble would also be disposed in RFETS landfill. There was no detectable asbestos, rad, or Be found in the structures.

Attached for your information is a copy of the Statement of Work for the demolition subcontractor.

Demolition is planned during September 1996, and will be completed in the same month, to meet K-H's performance measure.

ADMIN RECD

IA-A-000713

Best Available Copy

1/16

September 13, 1996  
S. M. Nesta  
DRM-003-96  
Page 2

RESPONSE REQUIREMENTS

Please provide a NEPA review for the project, keeping within the project schedule. Thank you for your assistance and support. If you have any questions, please contact me at X2084, or D5654.


Attachment:  
As Stated

DRM:dlu

cc:

R. Gurule K-H 371 w/o attach.

C. L. Guthrie RMRS T130F " "  
Corres Control RMRS 080

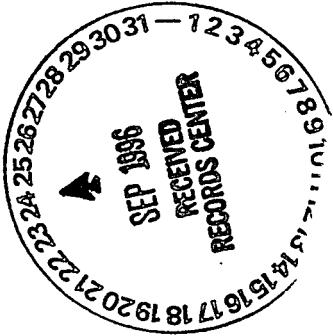

2

**STATEMENT OF WORK  
FOR  
REMOVAL OF BUILDING 461 AND 446 GUARD POSTS**

**Prepared by:  
Engineering/Construction/Decommissioning  
Rocky Mountain Remediation Services, L.L.C.  
Rocky Flats Environmental Technology Site**

**Authorization Number: 955011**

**Revision 1  
September 11, 1996**

## **1.0 INTRODUCTION**

- 1.1 This Statement of Work (SOW) describes the required Subcontractor services for removal of the Building 461 and 446 Guard Posts at the Rocky Flats Environmental Technology Site (RFETS).
- 1.2 This work will be performed for Rocky Mountain Remediation Services, LLC (RMRS) hereafter referred to as the Contractor.
- 1.3 For purposes of this SOW deactivation, decontamination, dismantlement, and removal of the guard posts will be referred to as "demolition."
- 1.4 *Use existing Health & Safety, Quality Assurance, and other plans from the original Fuel Oil Storage Tanks Removal Project. Modify as required to meet the requirements of this contract modification.*

## **2.0 SCOPE**

The Subcontractor shall provide labor, equipment, and materials to demolish the two guard posts. All work shall be completed by September 30, 1996. The work will include, but may not be limited to the following. The sequence listed does not necessarily reflect the sequence in which the actual demolition work will be performed.

### **2.1 Building 461 Guard Post**

- 2.1.1 Remove all items inside the guard post that have not been removed by the contractor. The Contractor will remove all furniture.
- 2.1.2 Remove electrical items including lights, panels, transformer, disconnect boxes, conduit, and wires from the interior and exterior of the guard post. Cut all underground electrical feeds flush with the top of the floor slab, and cap or seal with grout.
  - 2.1.2.1 Disconnect the end of the 480 volt feeder conductors from the service disconnect switch inside the guard post.
  - 2.1.2.2 Disconnect the 120 volt conductors from the UPS panel inside the guard post.
  - 2.1.2.3 Pull both sets of conductors together, which share the same underground conduit, in the direction of Building 460. This is accomplished from the junction box in the southwest corner of Room 104 in Building 460.
  - 2.1.2.4 Remove the 120 volt conductors from the junction box. Coil up and stow the 480 volt conductors in the junction box.

- 2.1.2.5 Disconnect the 277 volt conductors from the access ~~post~~ *port* at the Security Lighting Standard. Pull the conductors out of the underground conduit in the direction of the guard post.
- 2.1.3 Relocate the sprinkler system controller from the north side of the guard post to the ~~outside, south wall~~ *inside lobby* of Building 460. Run underground 24 volt wires from the controller to the junction outside the southwest corner of the guard post. Install an underground junction box at the tie-in. The Contractor will provide 110 volt power to the controller from Building 460.
- 2.1.4 Remove all security systems, panels, outside antenna, conduit and wire. Cut feeds flush with the top of the floor slab, and cap or fill with grout.
- 2.1.5 Remove all plumbing fixtures and piping. Cut the underground domestic water and sanitary feeds at the slab, and cap or seal with grout.
- 2.1.6 Remove all HVAC and other mechanical equipment not removed by the Contractor. The Contractor will remove the air handling unit and the outdoor condensing unit.
- 2.1.7 Remove the guard post down to the slab. The floor slab and footings are to remain in place.
- 2.1.9 Remove the railing and bollards on the east side of the guard post.
- 2.1.10 Remove the gate opener across the street from the east side of the guard post.
- 2.2 Building 446 Guard Post**
- 2.2.1 Remove all items inside the guard post not removed by the Contractor. The Contractor will remove all furniture.
- 2.2.2 Remove electrical items including lights, panels, transformers, disconnect boxes, conduit, and wires from the interior and exterior of the guard post. Cut all underground electrical feeds at the floor slab, and cap or seal with grout.
- 2.2.2.1 Pull the 480 volt feeder conductors from Building 444 out of the underground conduit in the direction of the guard post.
- 2.2.3 Remove all security systems, panels, outside antenna, conduit and wire. Cut feeds at the floor slab, and cap or fill with grout.

- 2.2.4 Remove the guard post down to the slab. The floor slab including the floor tiles, and the footings are to remain in place.
- 2.2.5 Remove the railing and bollards on the east side of the guard post.
- 2.2.6 Pave over the slab with a minimum 3 inches of asphalt. The pavement shall comply with RFETS Specification 02600.

### **3.0 GENERAL BACKGROUND**

The Building 461 and 446 Guard Posts are no longer needed for security at RFETS. The guard posts were used to limit access to the "400" area buildings. A description of the guard posts is as follows (see attached drawings for additional information):

#### Building 461 Guard Post

- Approximately 16 x 16 feet by 10 feet high concrete block structure.
- Spread footings with concrete slab floor.
- Flat membrane roof.
- Impact resistant, insulated glass windows.
- Lavatory with sink, domestic water and sanitary piping, and electric water cooler and heater.
- HVAC system with air handling unit, ductwork, heat pump and exhaust fan.
- Electrical panels, disconnects, conduit and wiring.
- Alarm and telephone boxes and wiring.

#### Building 446 Guard Post

- Approximately 23 x 14 feet by 10 feet high concrete structure with windows.
- Spread footings with concrete slab floor.
- Flat membrane roof.
- Electric heaters.
- Electrical panels, disconnects, conduit and wiring.
- Alarm and telephone boxes and wiring.

### **4.0 TECHNICAL REQUIREMENTS**

- 4.1 The Subcontractor shall make a pre-award, pre-proposal walkdown of the work area.
- 4.2 The demolition shall comply with RFETS Specification 02110 and applicable Division I specifications.
- 4.3 An underground utilities survey shall be performed by the Contractor prior to commencing demolition activities. The Subcontractor shall verify the location of utilities

prior to the start of demolition, *and perform a no load/no voltage verification prior to the start of demolition.*

- 4.4 Compliance with OSHA regulations related to the work is mandatory. This may include, but is not limited to 29 CFR Subpart T, Demolition and 29 CFR 1926.62 Lead.
- 4.5 ~~Removal of asbestos containing material shall comply with 29 CFR 1926.1101 and RFETS Specification 02082. It is assumed all asbestos containing material is non-friable and can be handled in accordance with Section 3.03.1 of 02082.~~
- 4.6 All electrical and mechanical lockouts will be performed by the Contractor. The Subcontractor must verify the de-energized status.
- 4.7 All electrical and mechanical disconnections or terminations inside Buildings 460 or 444 will be performed by the Contractor.
- 4.8 All equipment or items that can be reused by the Contractor shall be hauled by the Subcontractor to RFETS Property Utilization & Disposal (PU&D). All recyclable metals shall be placed in a dumpster provided at the job site by the Contractor.
- 4.9 All Demolition debris that does not go to PU&D will be hauled by the Subcontractor to the RFETS Sanitary Landfill.
- 4.10 The Subcontractor shall provide a unit price to haul all debris which are not recycled offsite.
- 4.11 The Subcontractor shall provide a unit price per square foot for the removal and disposal of asbestos material if encountered.
- 4.12 *Both the 461 and 446 guard posts have lead paint. Demolition of structures where lead or materials containing lead are present shall comply with 26 CFR 1926.62 and a Subcontractor Lead Compliance Plan.*

## 5.0 DELIVERABLES

- 5.1 The Subcontractor shall provide a work sequence and methods to be used for the work two days after contract award.
- 5.2 The Subcontractor shall provide a *Health & Safety Plan Addendum and Activity Hazard Analyses Job Safety Analysis* for the project three days after contract award.
- 5.3 The Subcontractor will provide an Engineering Survey in accordance with 29 CFR, Subpart T, 1926.850(a) prior to the demolition.

## 6.0 ATTACHMENTS


The following reference drawings are included as part of this SOW. These drawings shall be used by the Subcontractor as a guide to the location and extent of the work to be performed under this SOW. These drawings have not been field verified and might not show existing conditions.


### Division 2 Specifications


- 02110 - Demolition
- 02600 - Asphalt Concrete Pavement
- 02082 - Removal and Disposal of Asbestos Material (applicable pages only)



### Drawings

37646-X01	Plot Plan
36002-300	Building 461 Plans & Elevations
36002-301	Building 461 Sections & Details
36002-401	Bldg. 461 HVAC & Plumbing
36002-508	Guard House Bldg. 461 (Electrical)
14346-1	Building 446 Floor Plan & Elevation
38503-115	Roof Replacement, Building 446
RF-46-300	Building 46 Power, Lighting, Telephone & Alarm Systems

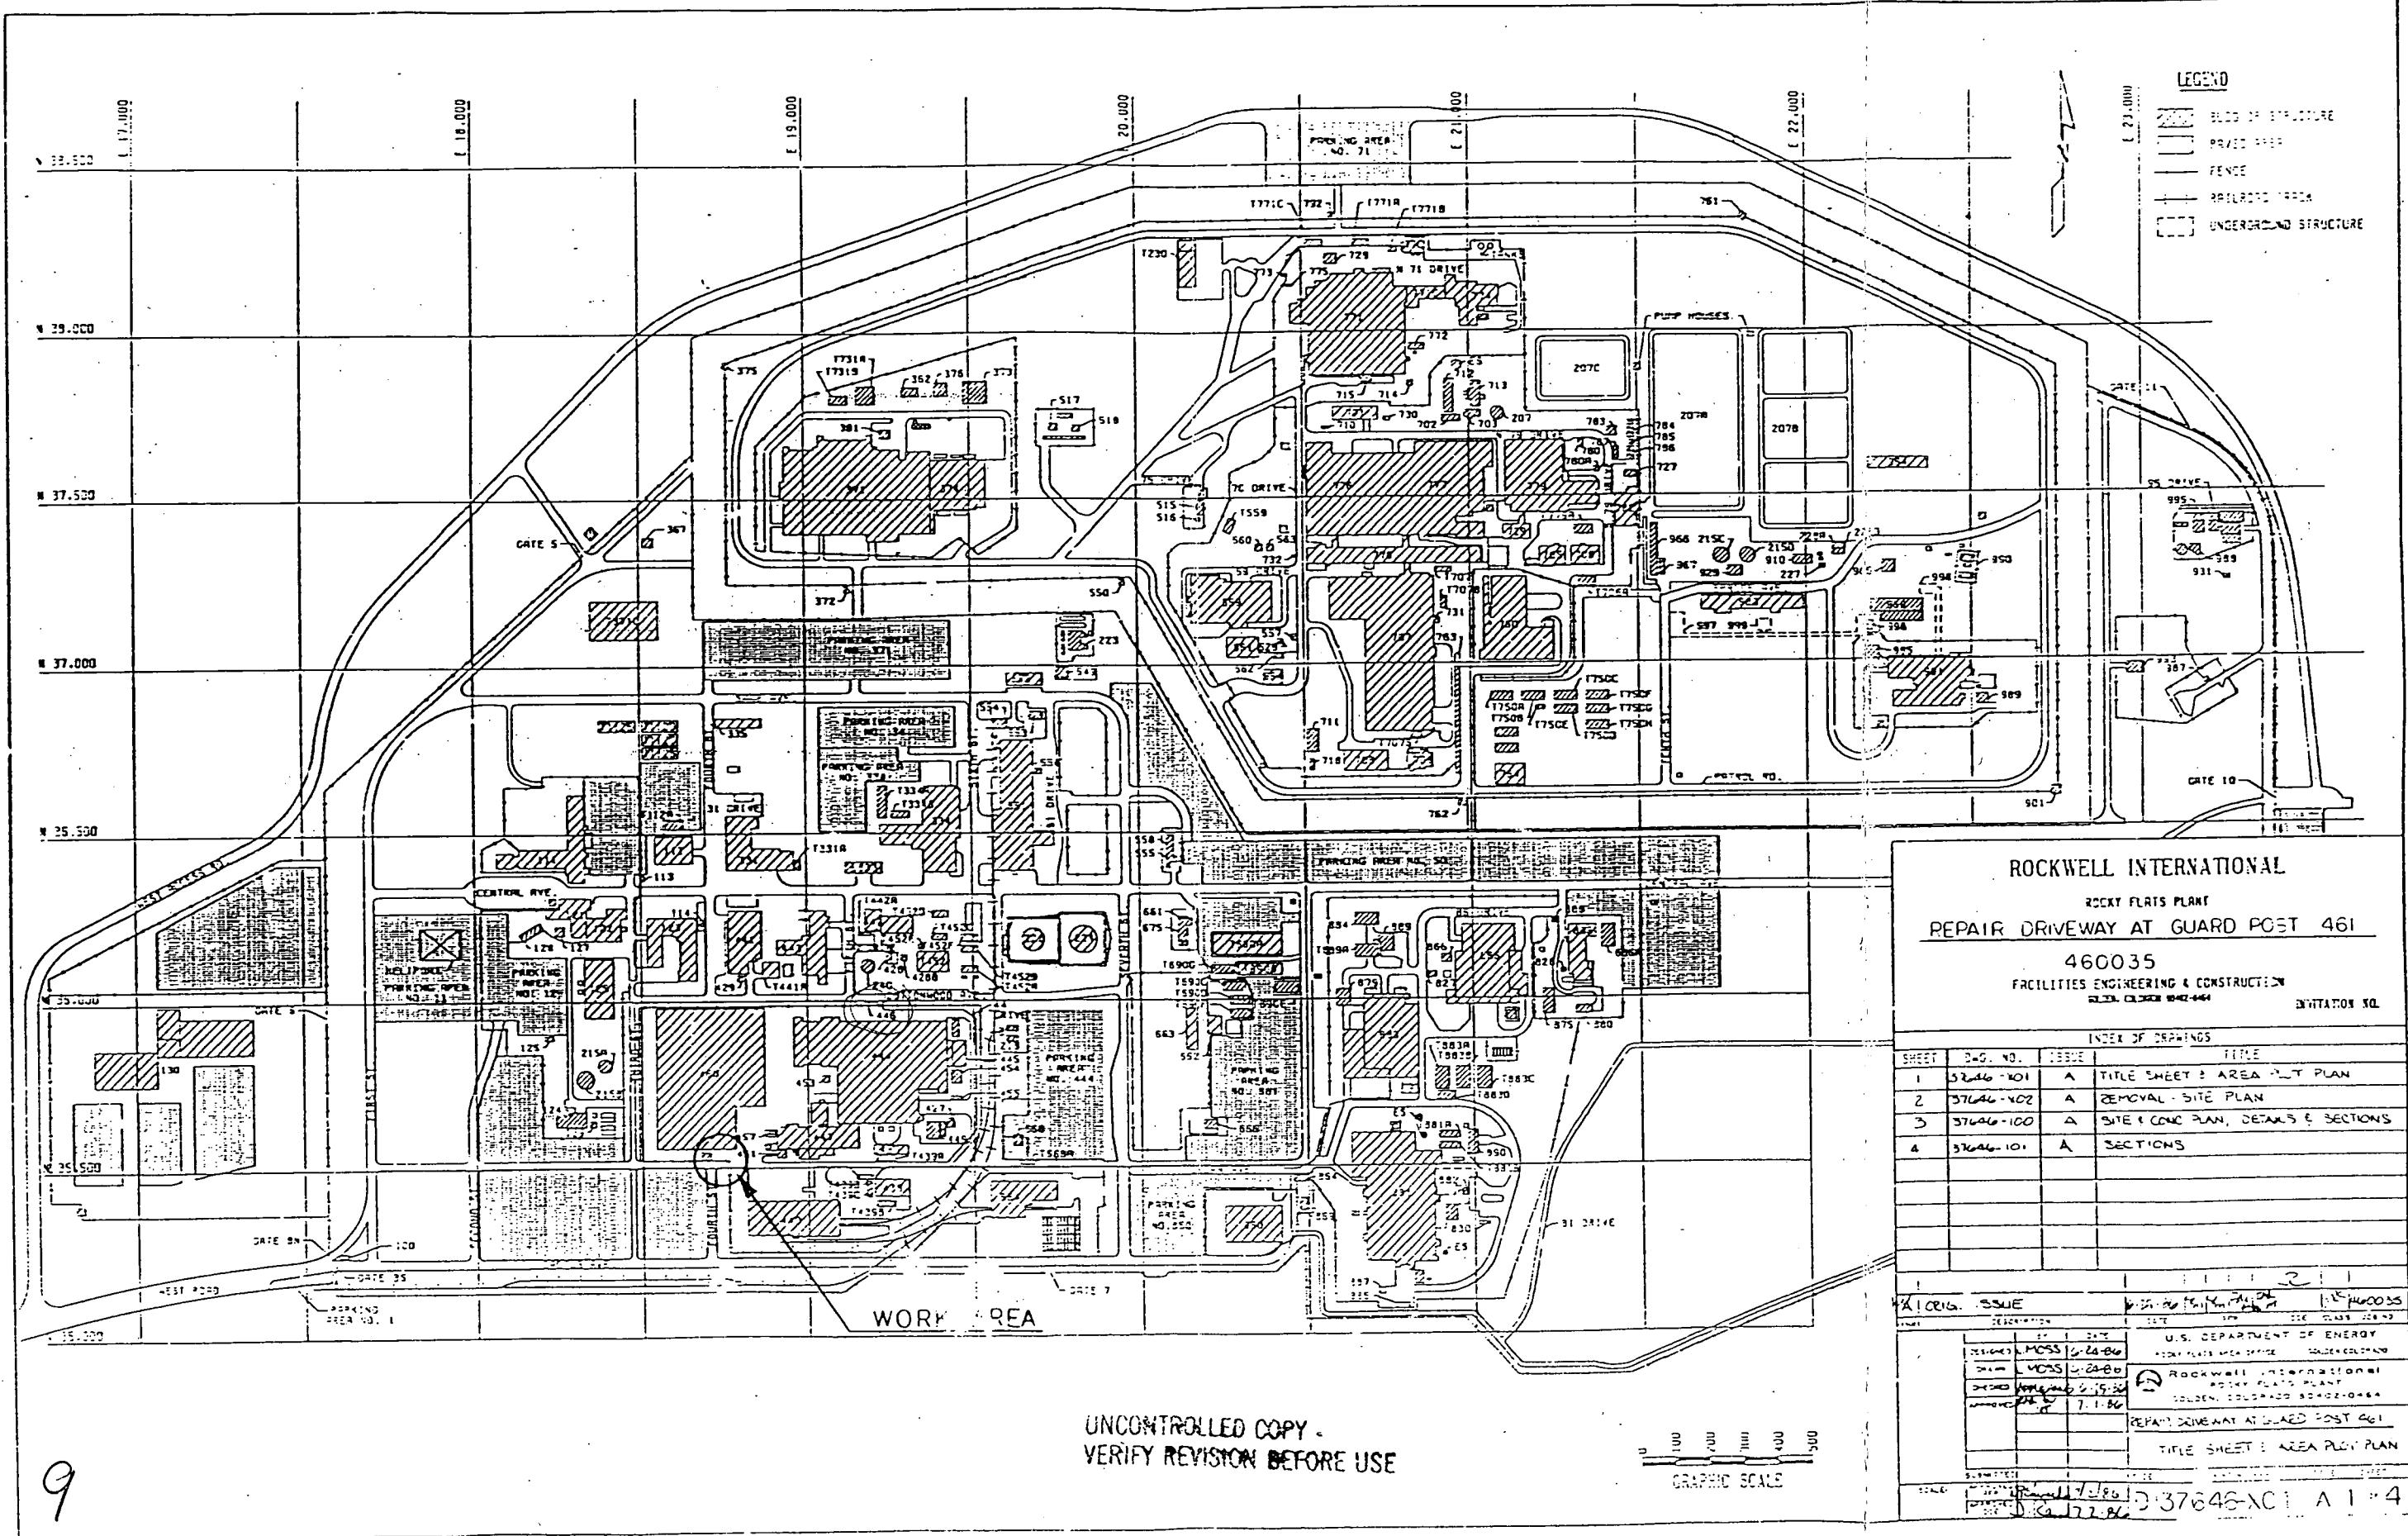


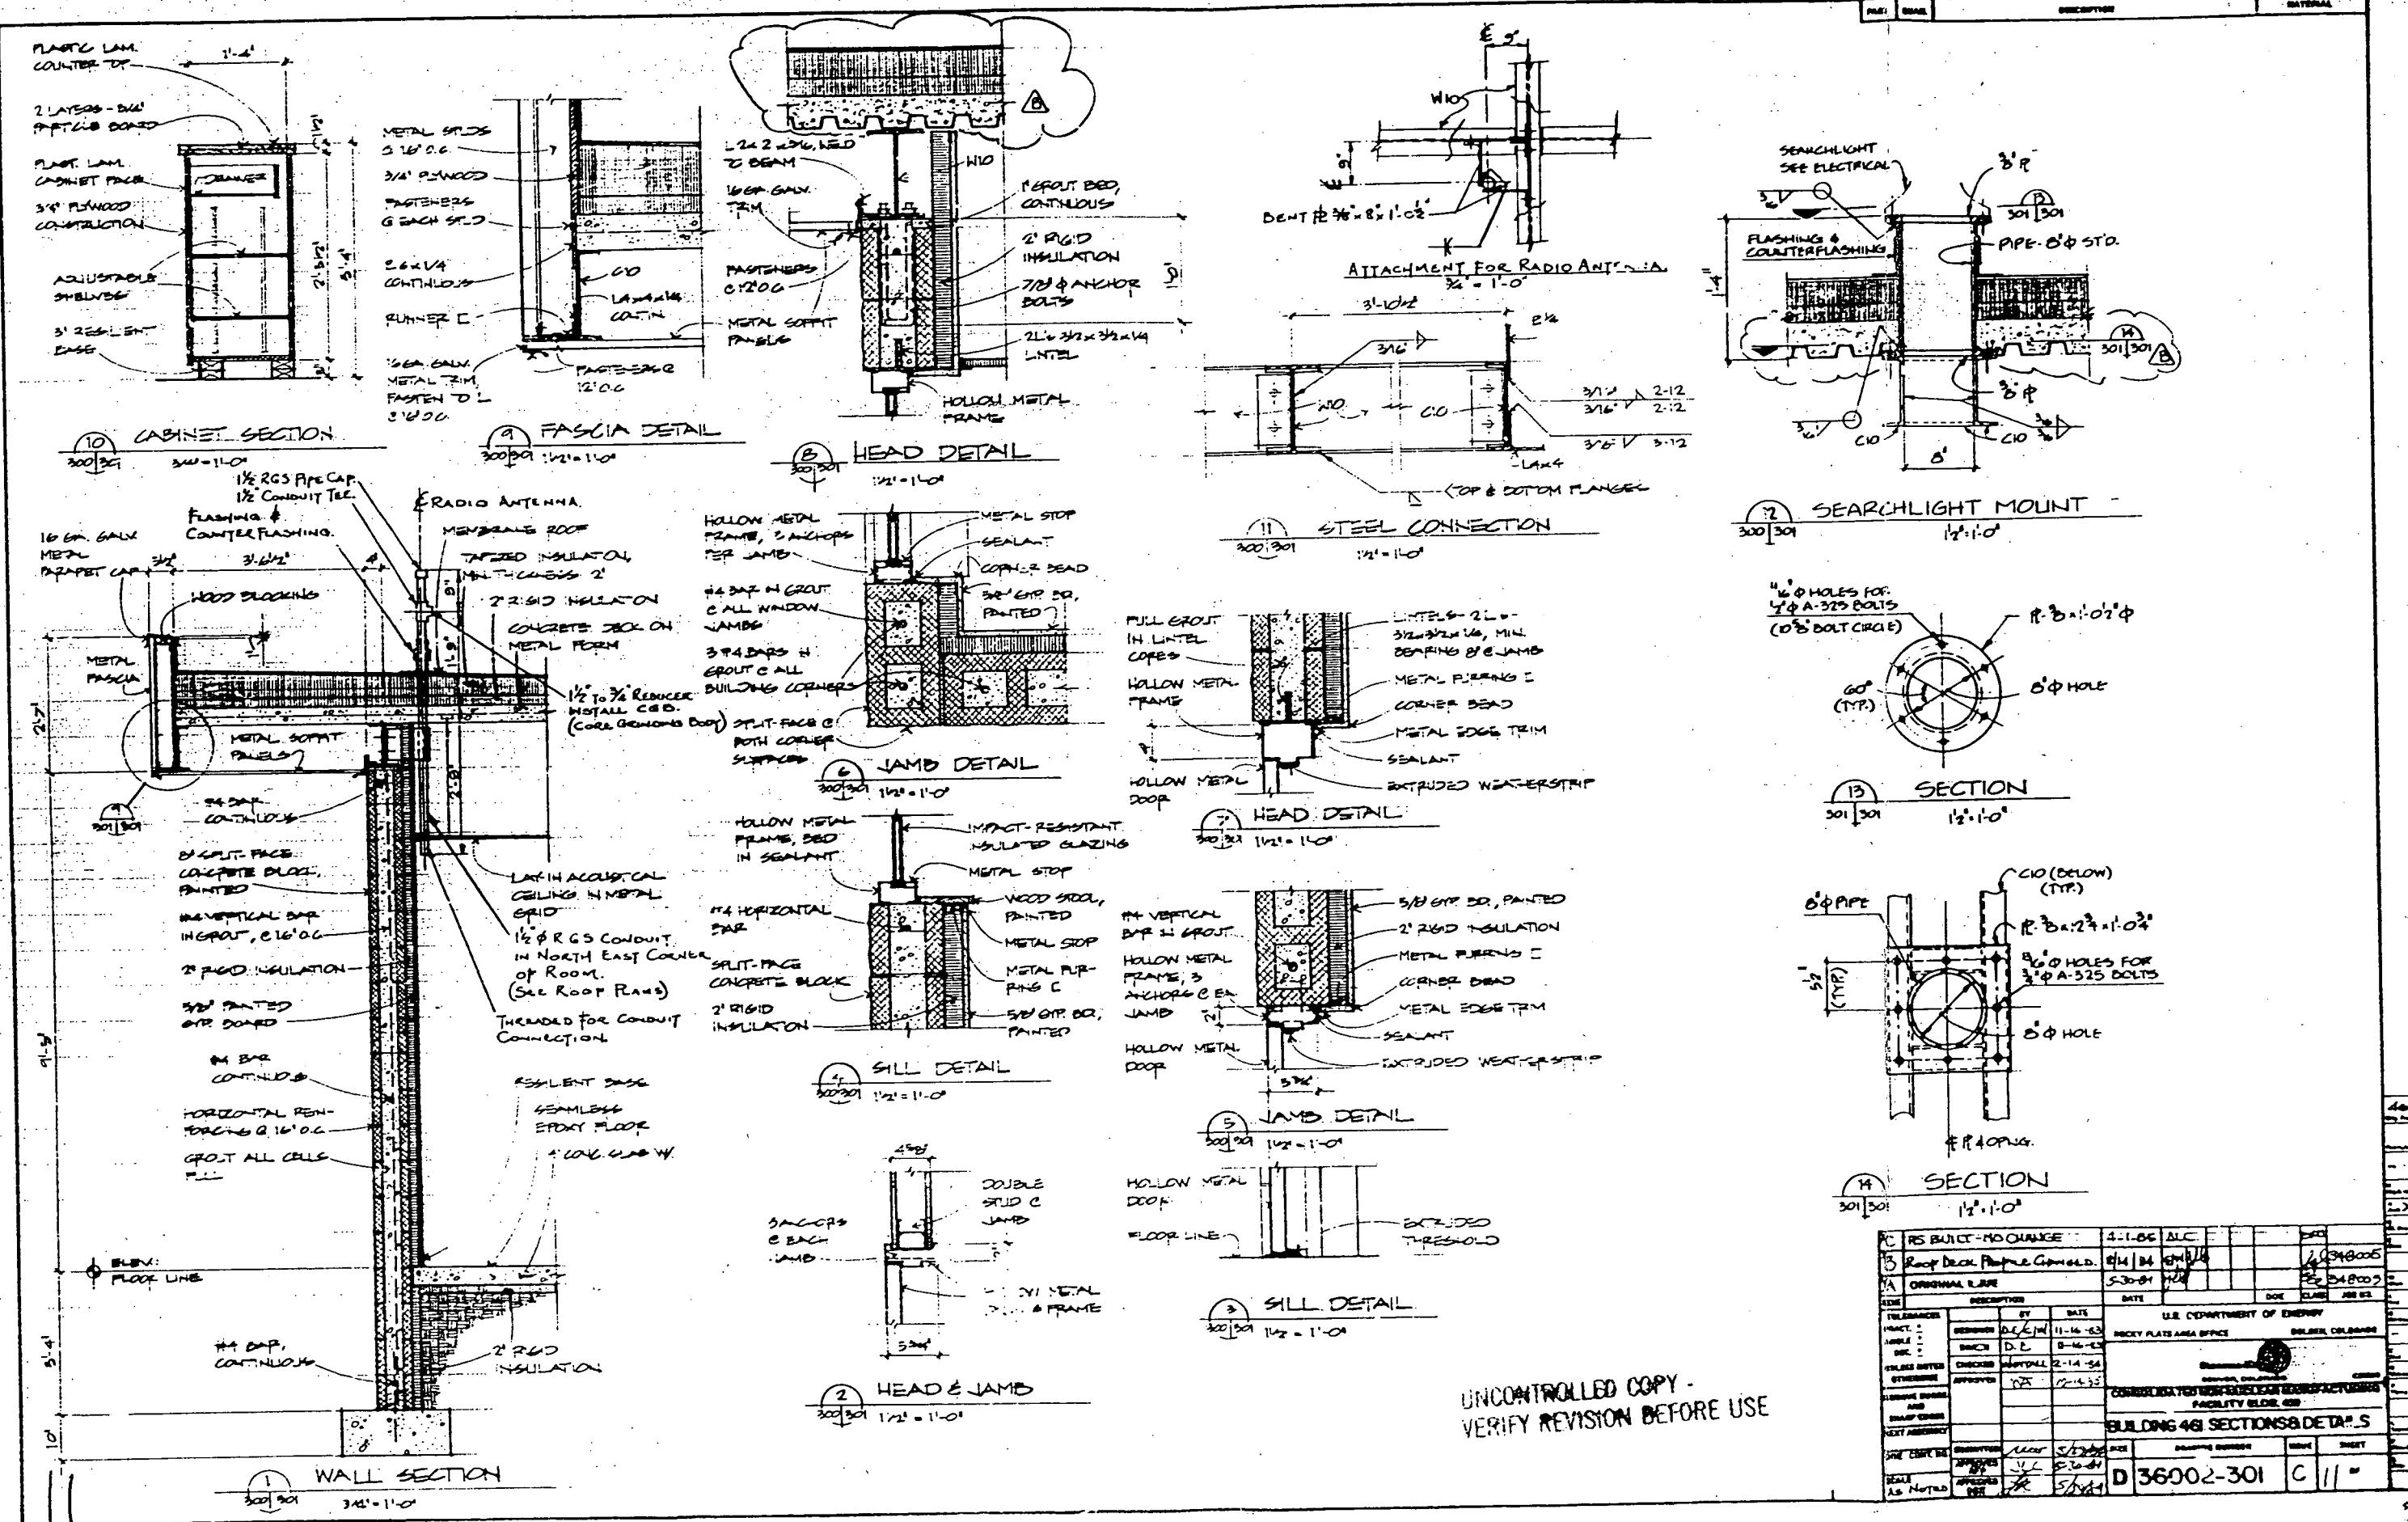

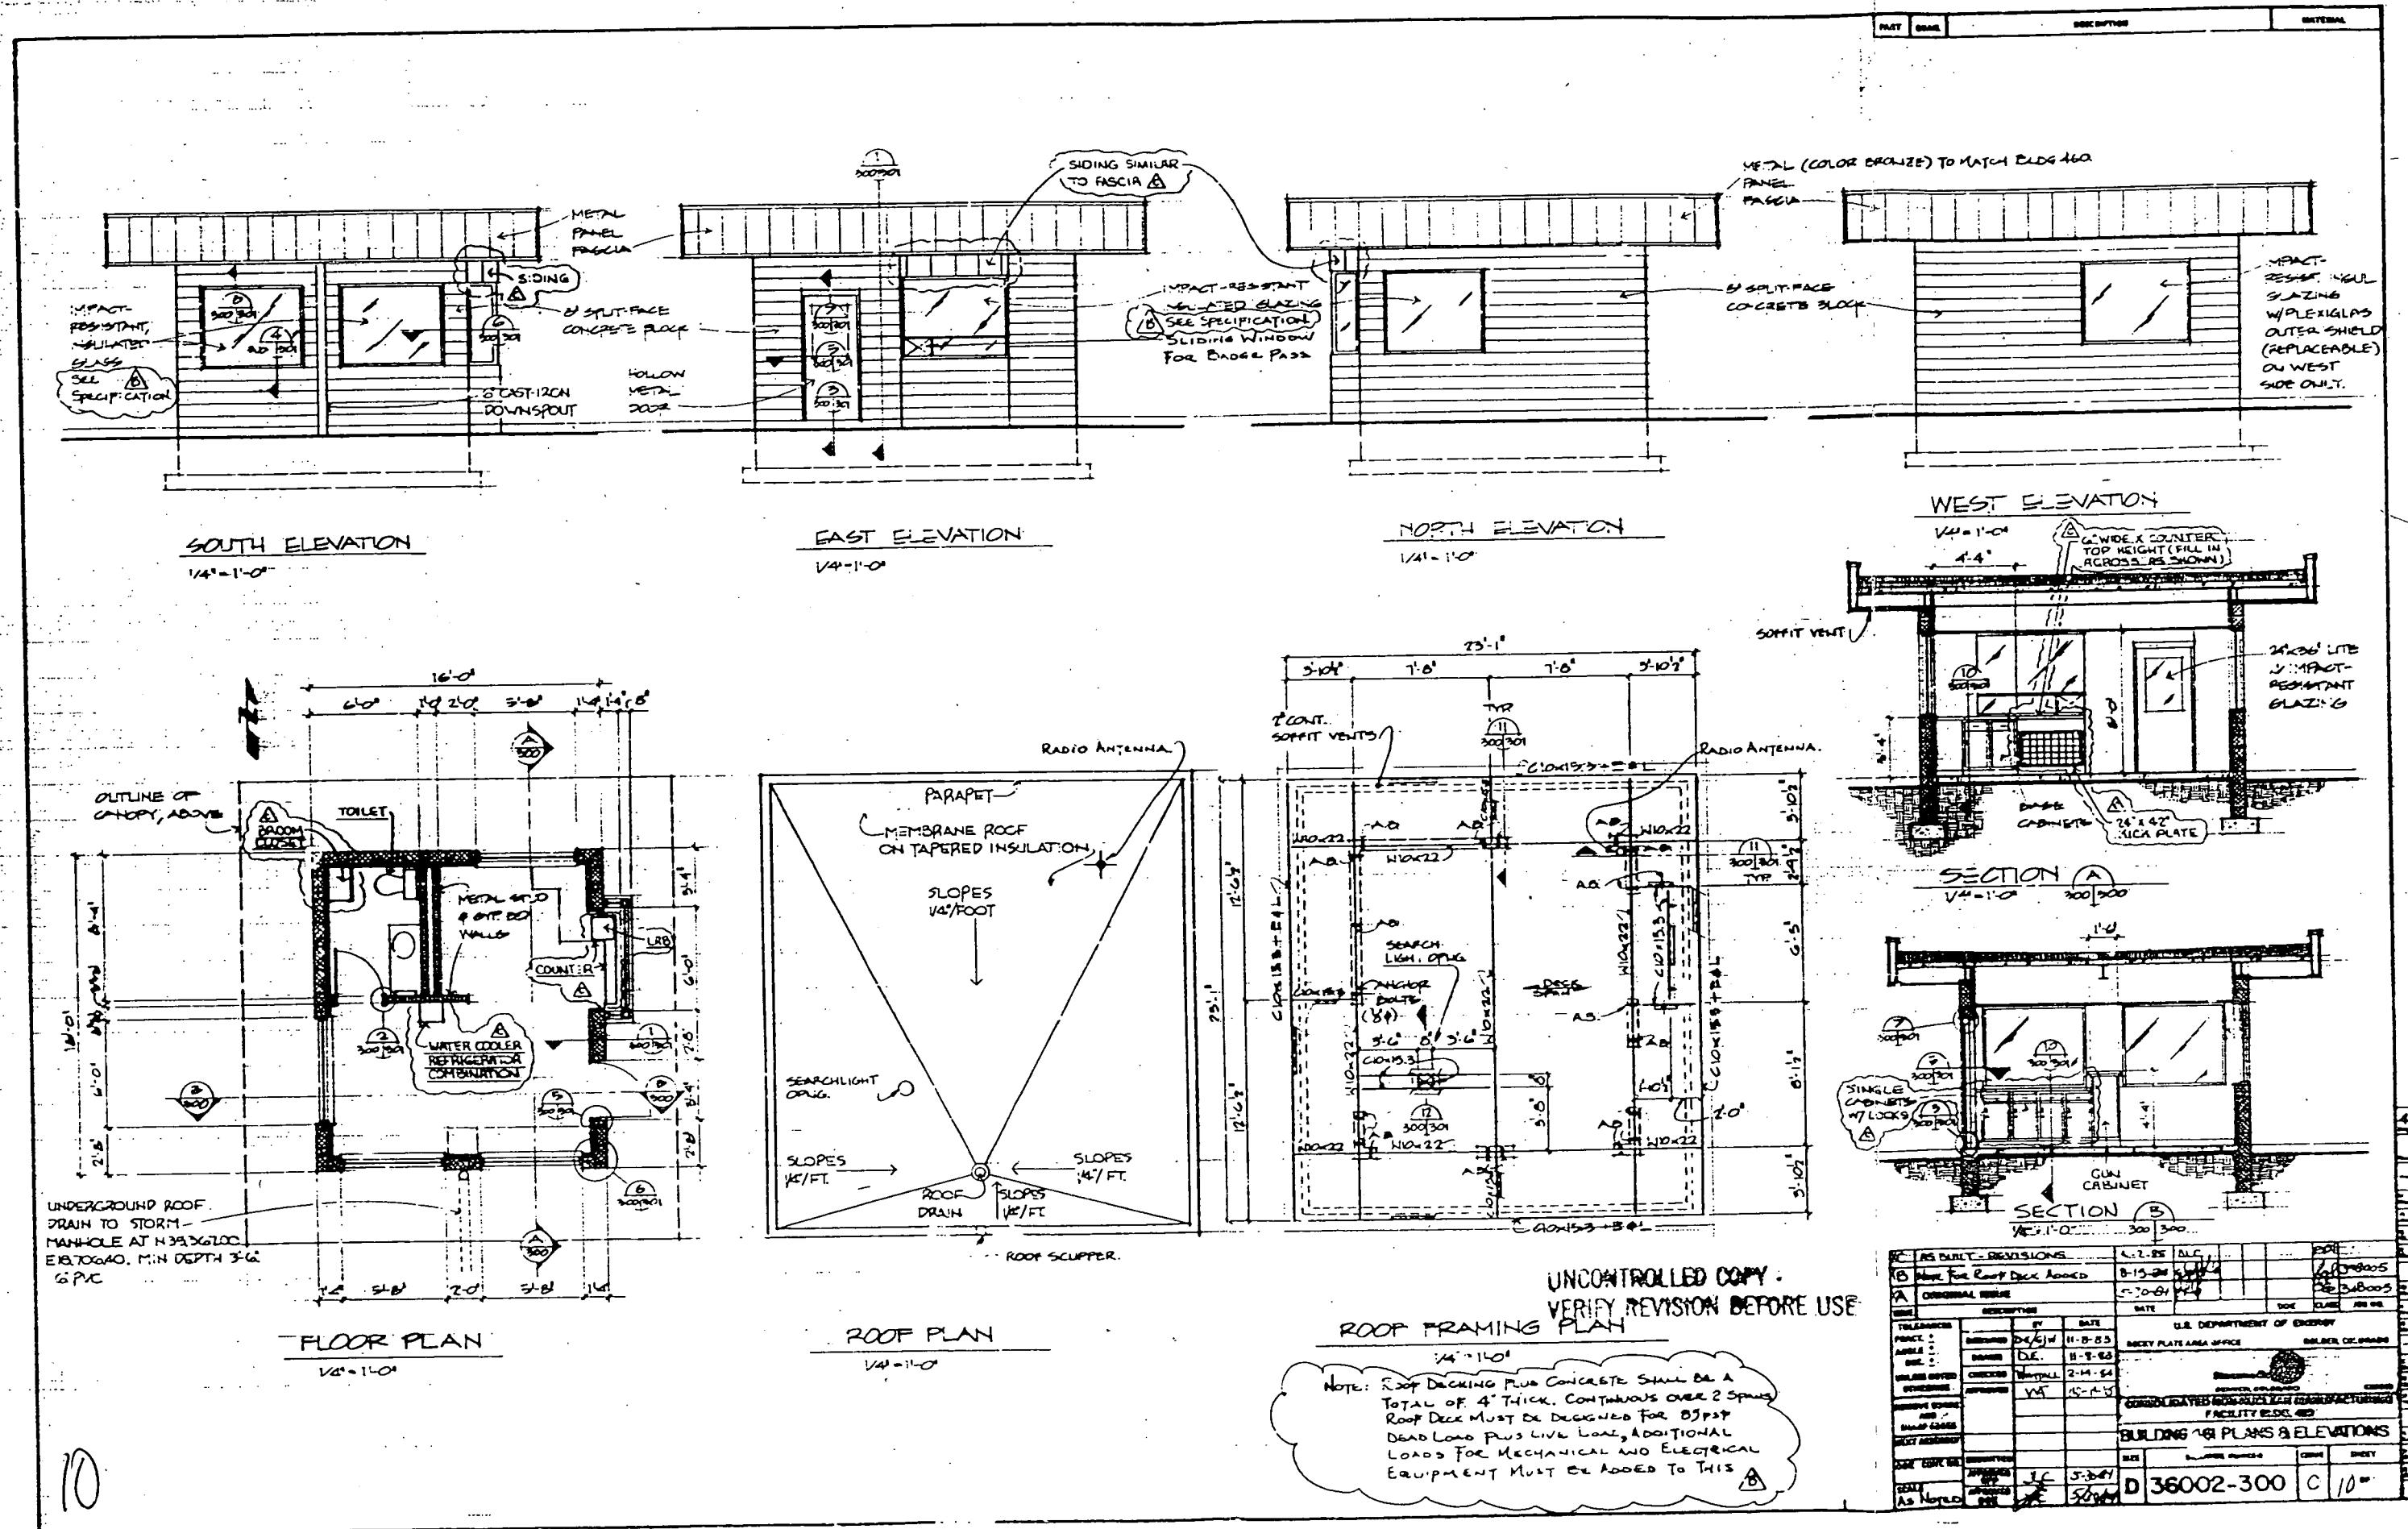

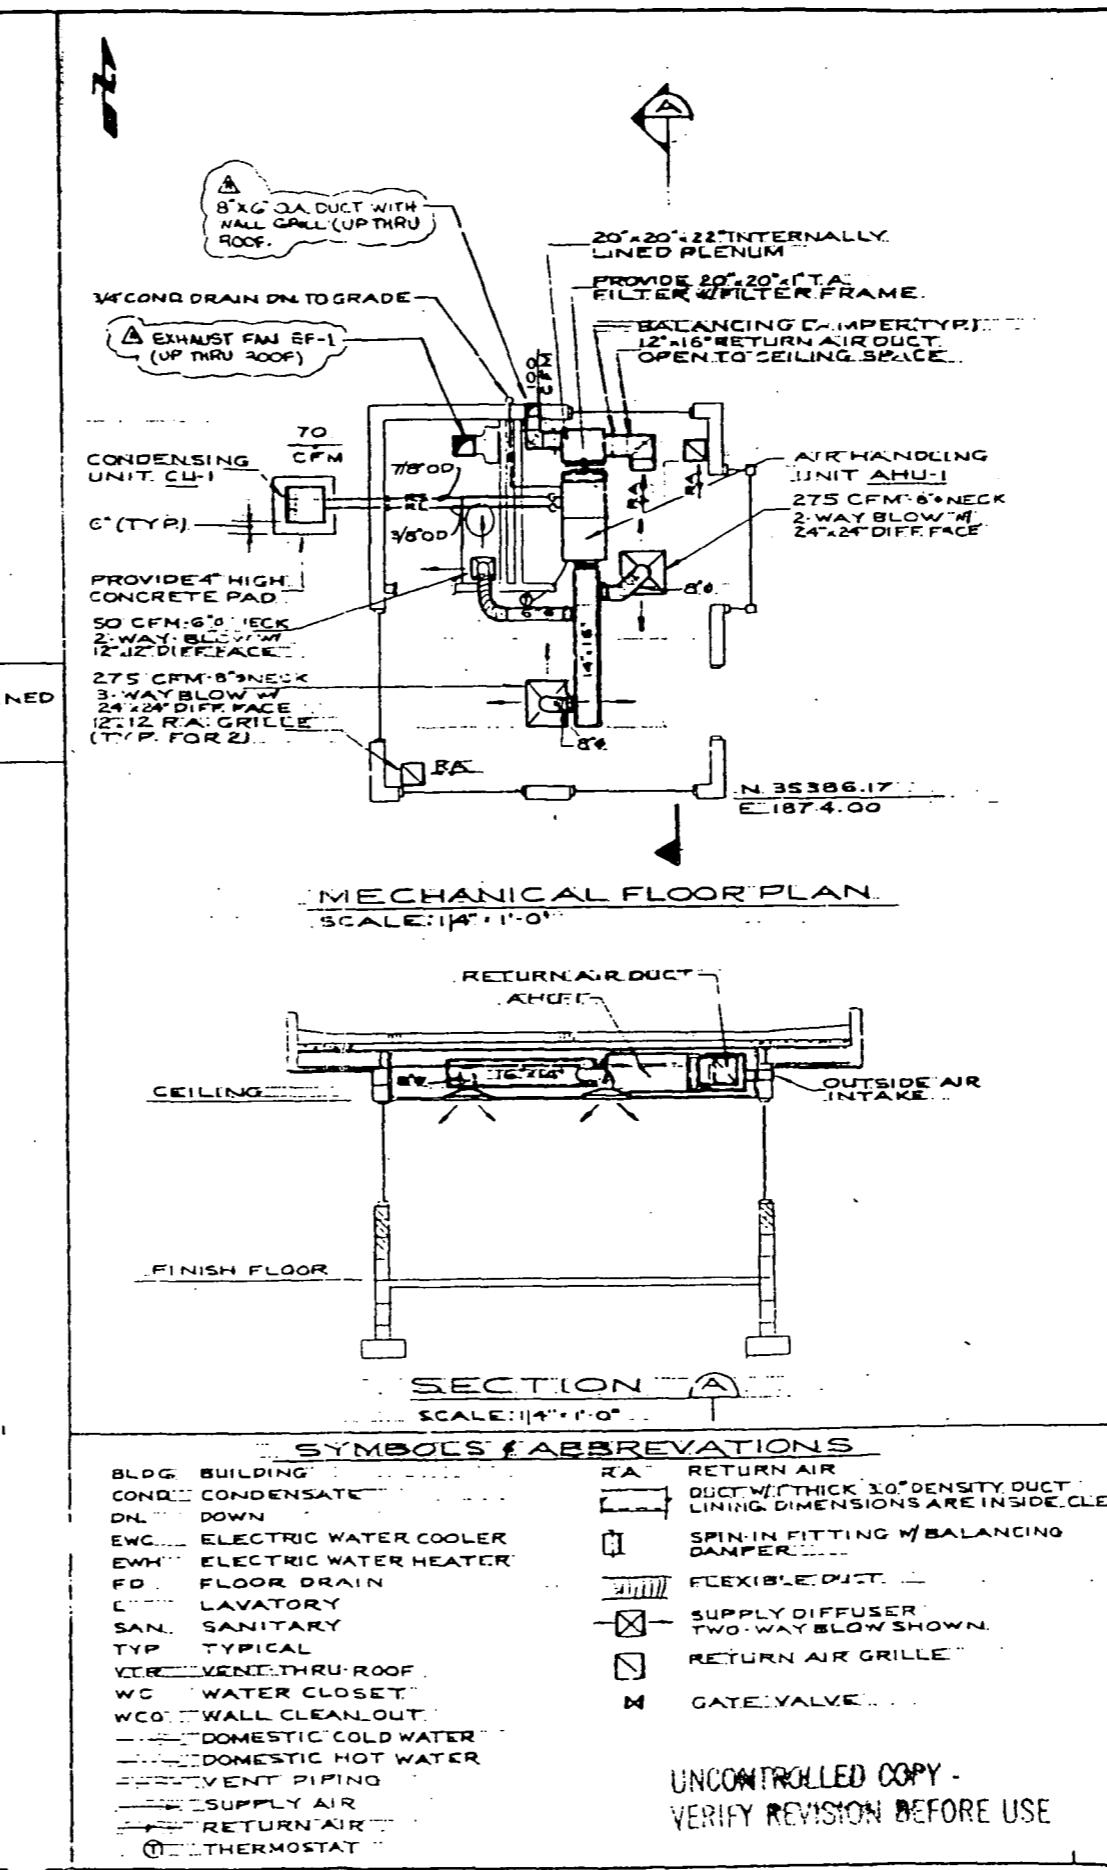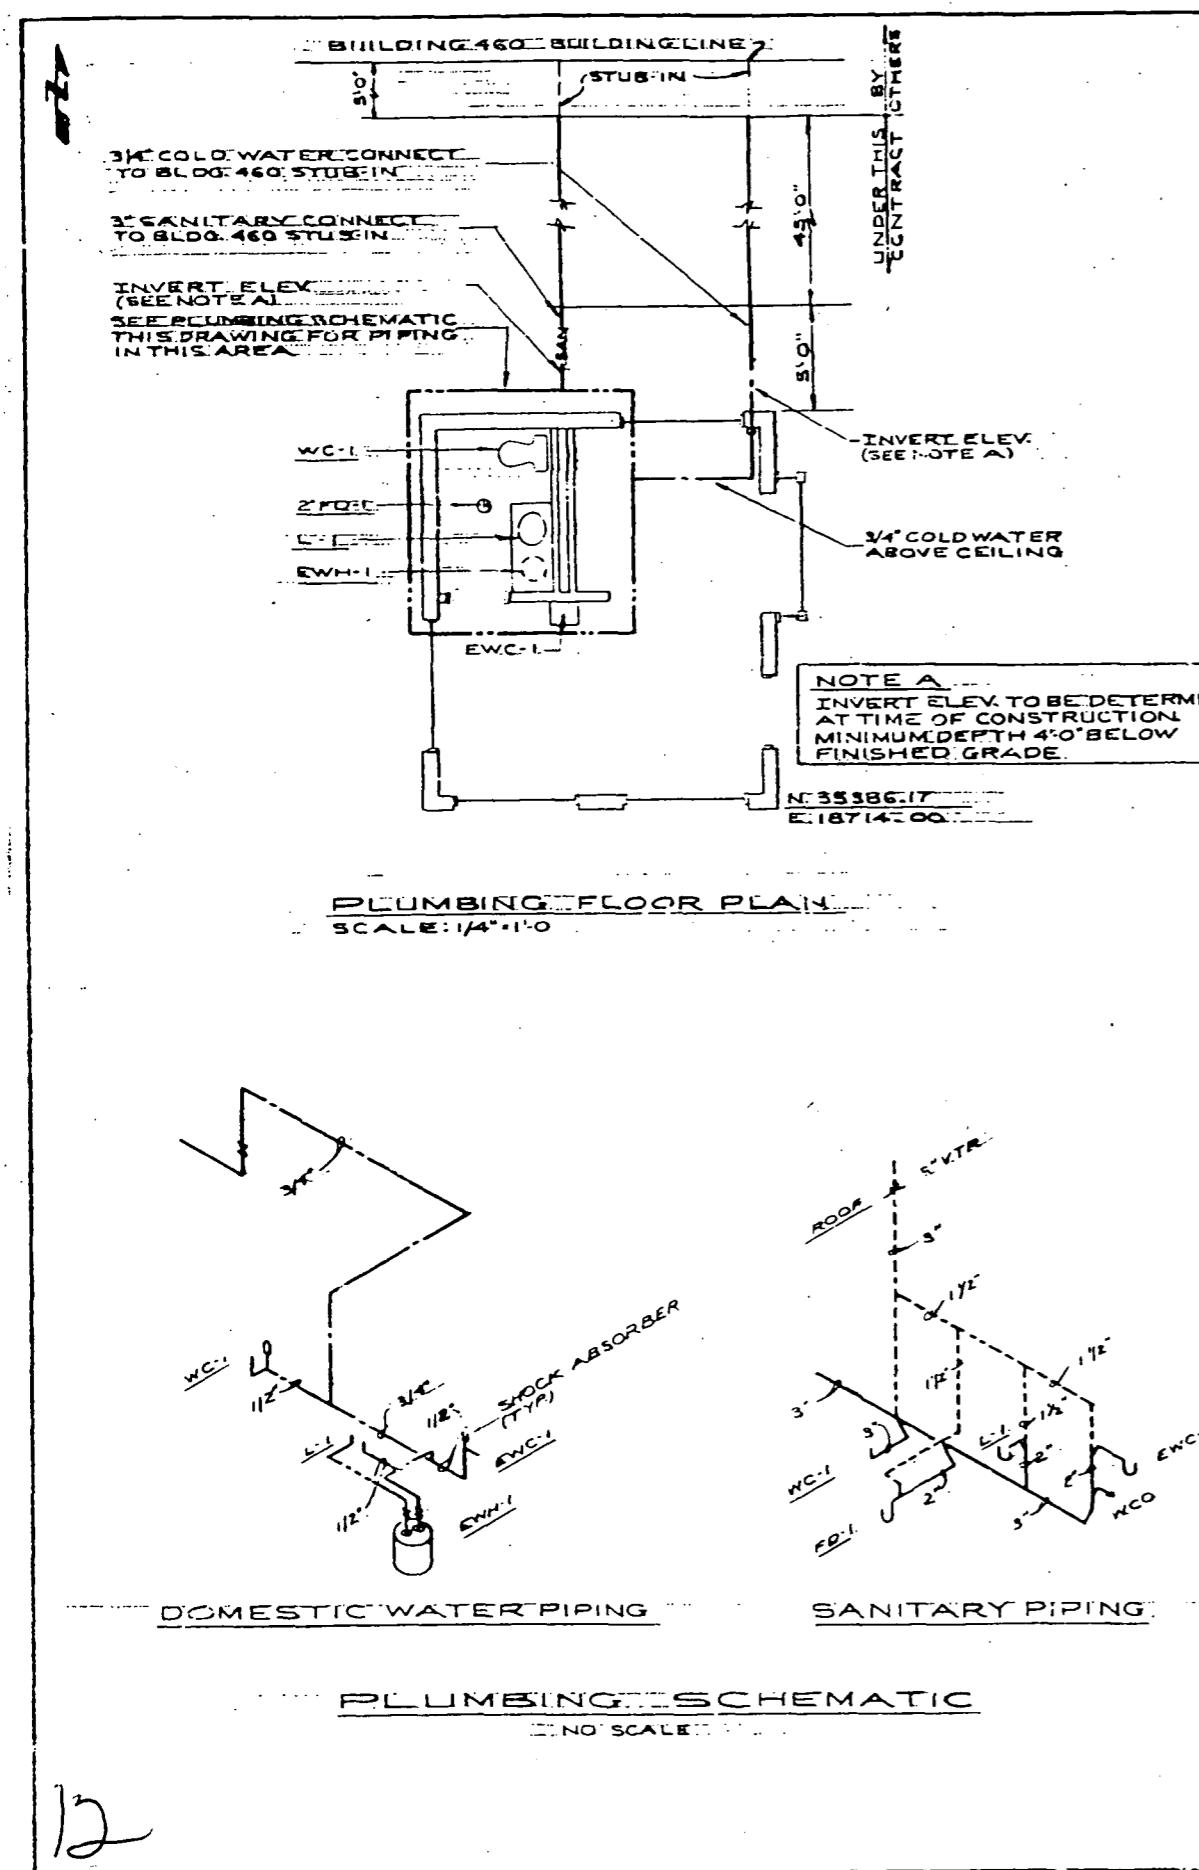

WORK	DESCRIPTION	MATERIAL
HEATING, VENTILATION, AIR CONDITIONING AND PLUMBING		
1. General Description: The work in this section consists of providing a complete heating, ventilating and air conditioning and plumbing systems in new Guard Post 461, as shown on this drawing.		
2. Ductwork: Ductwork shall be galvanized steel and shall be fabricated and installed in accordance with SMACNA Low Velocity Duct Construction Standards. All supply and return ductwork shall be lined with 1 inch thick fiberglass duct liner. Duct sizes are inside clear dimensions. Gromets shall be round flexible type, insulated with 1 inch insulation.		
3. Ceiling Diffusers: Diffusers shall be multi-directional type with round neck connections. Diffusers shall be similar to Tuttle and Bailey perforated ceiling diffuser.		
4. Return Grilles: Grilles shall be of perforated face type and shall be adaptable for a drop-in ceiling grid system. Grilles shall be Tuttle and Bailey or equal.		
5. Jumper-fitting: Factory built sofit fitting connections shall be installed in the main duct. Jumpers shall be complete with wing nut and operator and shall be approved by SMACNA.		
6. Air Handling Unit AHU-1: G.E. weatherhead horizontal air handler complete with 30 cfm and supplementary 5.76 kw electric heating elements. Maximum cross section shall be 15-3/4 inch wide x 20-1/2 inch high. Unit shall be G.E. Model BMT 724P-1004 with matching outdoor compressor/condenser unit which shall be G.E. Model BMT 724A-1004 and shall be complete with refrigeration line kit, drain pan, automatic heat/cool (2-stage heating) thermostat and quick start kit. Unit shall be set for 600 cfm at 0.5" WG at 6,000 feet elevation with total cooling load of 11,000 Btuh, and total heating load = 17,700 Btuh. Unit shall be independently suspended from the roof structure with rubber or spring vibration isolators and shall be completely charged and ready for operation. Filters shall be throwaway type.		
7. Exhaust Fan EF-1: Fan shall be Penn Zephyr Model Z-6 ceiling fan. Units shall be complete with silent backdraft dampers, rubber vibration isolators and wall cap. Unit capacity shall be 70 cfm at 0.10" WG at 6,000 feet elevation and shall be AMCA certified.		
8. Plumbing Fixtures: The following fixtures shall be provided and installed in an approved manner complete with trap, supply and waste connections.		
A. AC-Water Closet: American Standard 42109.395 elongated water-saver "Ladel" toilet, floor mounted, tank type with white elongated seamless cover and chrome bolt caps.		
B. L-1 Lavatories: American Standard P0476.28, 4 inch centers "Aqualyn" lavatory with Chicago trim, self-closing valves at 0.25 gpm.		
C. Electric Water Heater: "Rheemglas" standard, Model No. 64-65, capacity of 6 gallons, 208V/1/60.		
D. EMC-1 Electric Water Cooler: Cordley PWA-6 with stainless steel top, 6 gpm at 50 degrees F.		
9. Pipe and Fittings: All pipe and fittings shall be as follows:		
A. Domestic Water: Type K hard copper, ASTM B-88 with wrought copper solder joints, ANSI B16.22.		
B. Refrigeration Piping: Type L hard copper tube to ASTM B-88 Mueller, "ZEM". Factory cleaned, nitrogen charged and plugged with wrought copper solder joint fitting to ANSI B16.22.		
C. Sanitary Sewer and Vents:		
Within Building: Cast iron pipe, ASTM A74, service weight, hub & plain end with cast iron, ASTM A74, service weight fittings, with ring joint gaskets.		
Beyond 5'-0" of foundation: PVC, Rigid, Schedule 40, Plain Ends, ASTM D-1784, Type I, Grade 1 and ASTM D-1785, with Schedule 40, PVC Socket Type Fittings, ASTM D-1784, Type I, Grade 1 and ASTM D-2467.		
D. FD-1 Floor Drains: Josam 30600A, cast iron floor drain with adjustable strainer and integral "T" Trap.		
E. WCO Wall Clean-Out: Josam 58710-2Z with stainless steel access plate set flush with finished wall.		
F. Shock Absorbers: Josam Series 1405-121 stainless steel construction.		
10. Plumbing Installation and testing shall be in accordance with the Uniform Plumbing Code.		
11. Gate Valves:		
1254 Bronze: Soldered.		
Lundehammer 2133	1254 SHP Saturated	
Crane 1320	Bronze Body, Integral Seat	
Walworth 45J	Solid Wedge, Nonrising Stem	
Powell 1822	Screwed Bonnet	
12. Pipe Insulation:		
A. All water piping shall be insulated with 1" thick fiberglass pipe insulation sections with a factory applied prestressed glass cloth jacket, vapor barrier coating, and with sealing lamps. Longitudinal jacket laps and butt strips shall be smoothly secured in place using insulation manufacturer's recommendation for lap and butt strip sealing.		
B. Refrigerant suction lines shall be covered with 1 inch thick Armaflex per manufacturer's installation instructions.		
13. Domestic water piping shall be sterilized as prescribed by AMCA Standard C-601, and as determined by the Contracting Officer.		
14. Balancing and Adjusting: At the completion of the work, all mechanical systems shall be adjusted and balanced by a firm specializing in this work. The firm must have a registered professional engineer in charge of this work, must have experience and qualifications satisfactory to the Contracting Officer and must be approved by him before his work is begun. An outline test procedure and data forms shall be submitted for approval before work can begin.		
15. Cleanup: After all work is complete, remove all scraps, cartons, adhesive containers, and other debris from work areas and dispose of as directed by Contracting Officer.		

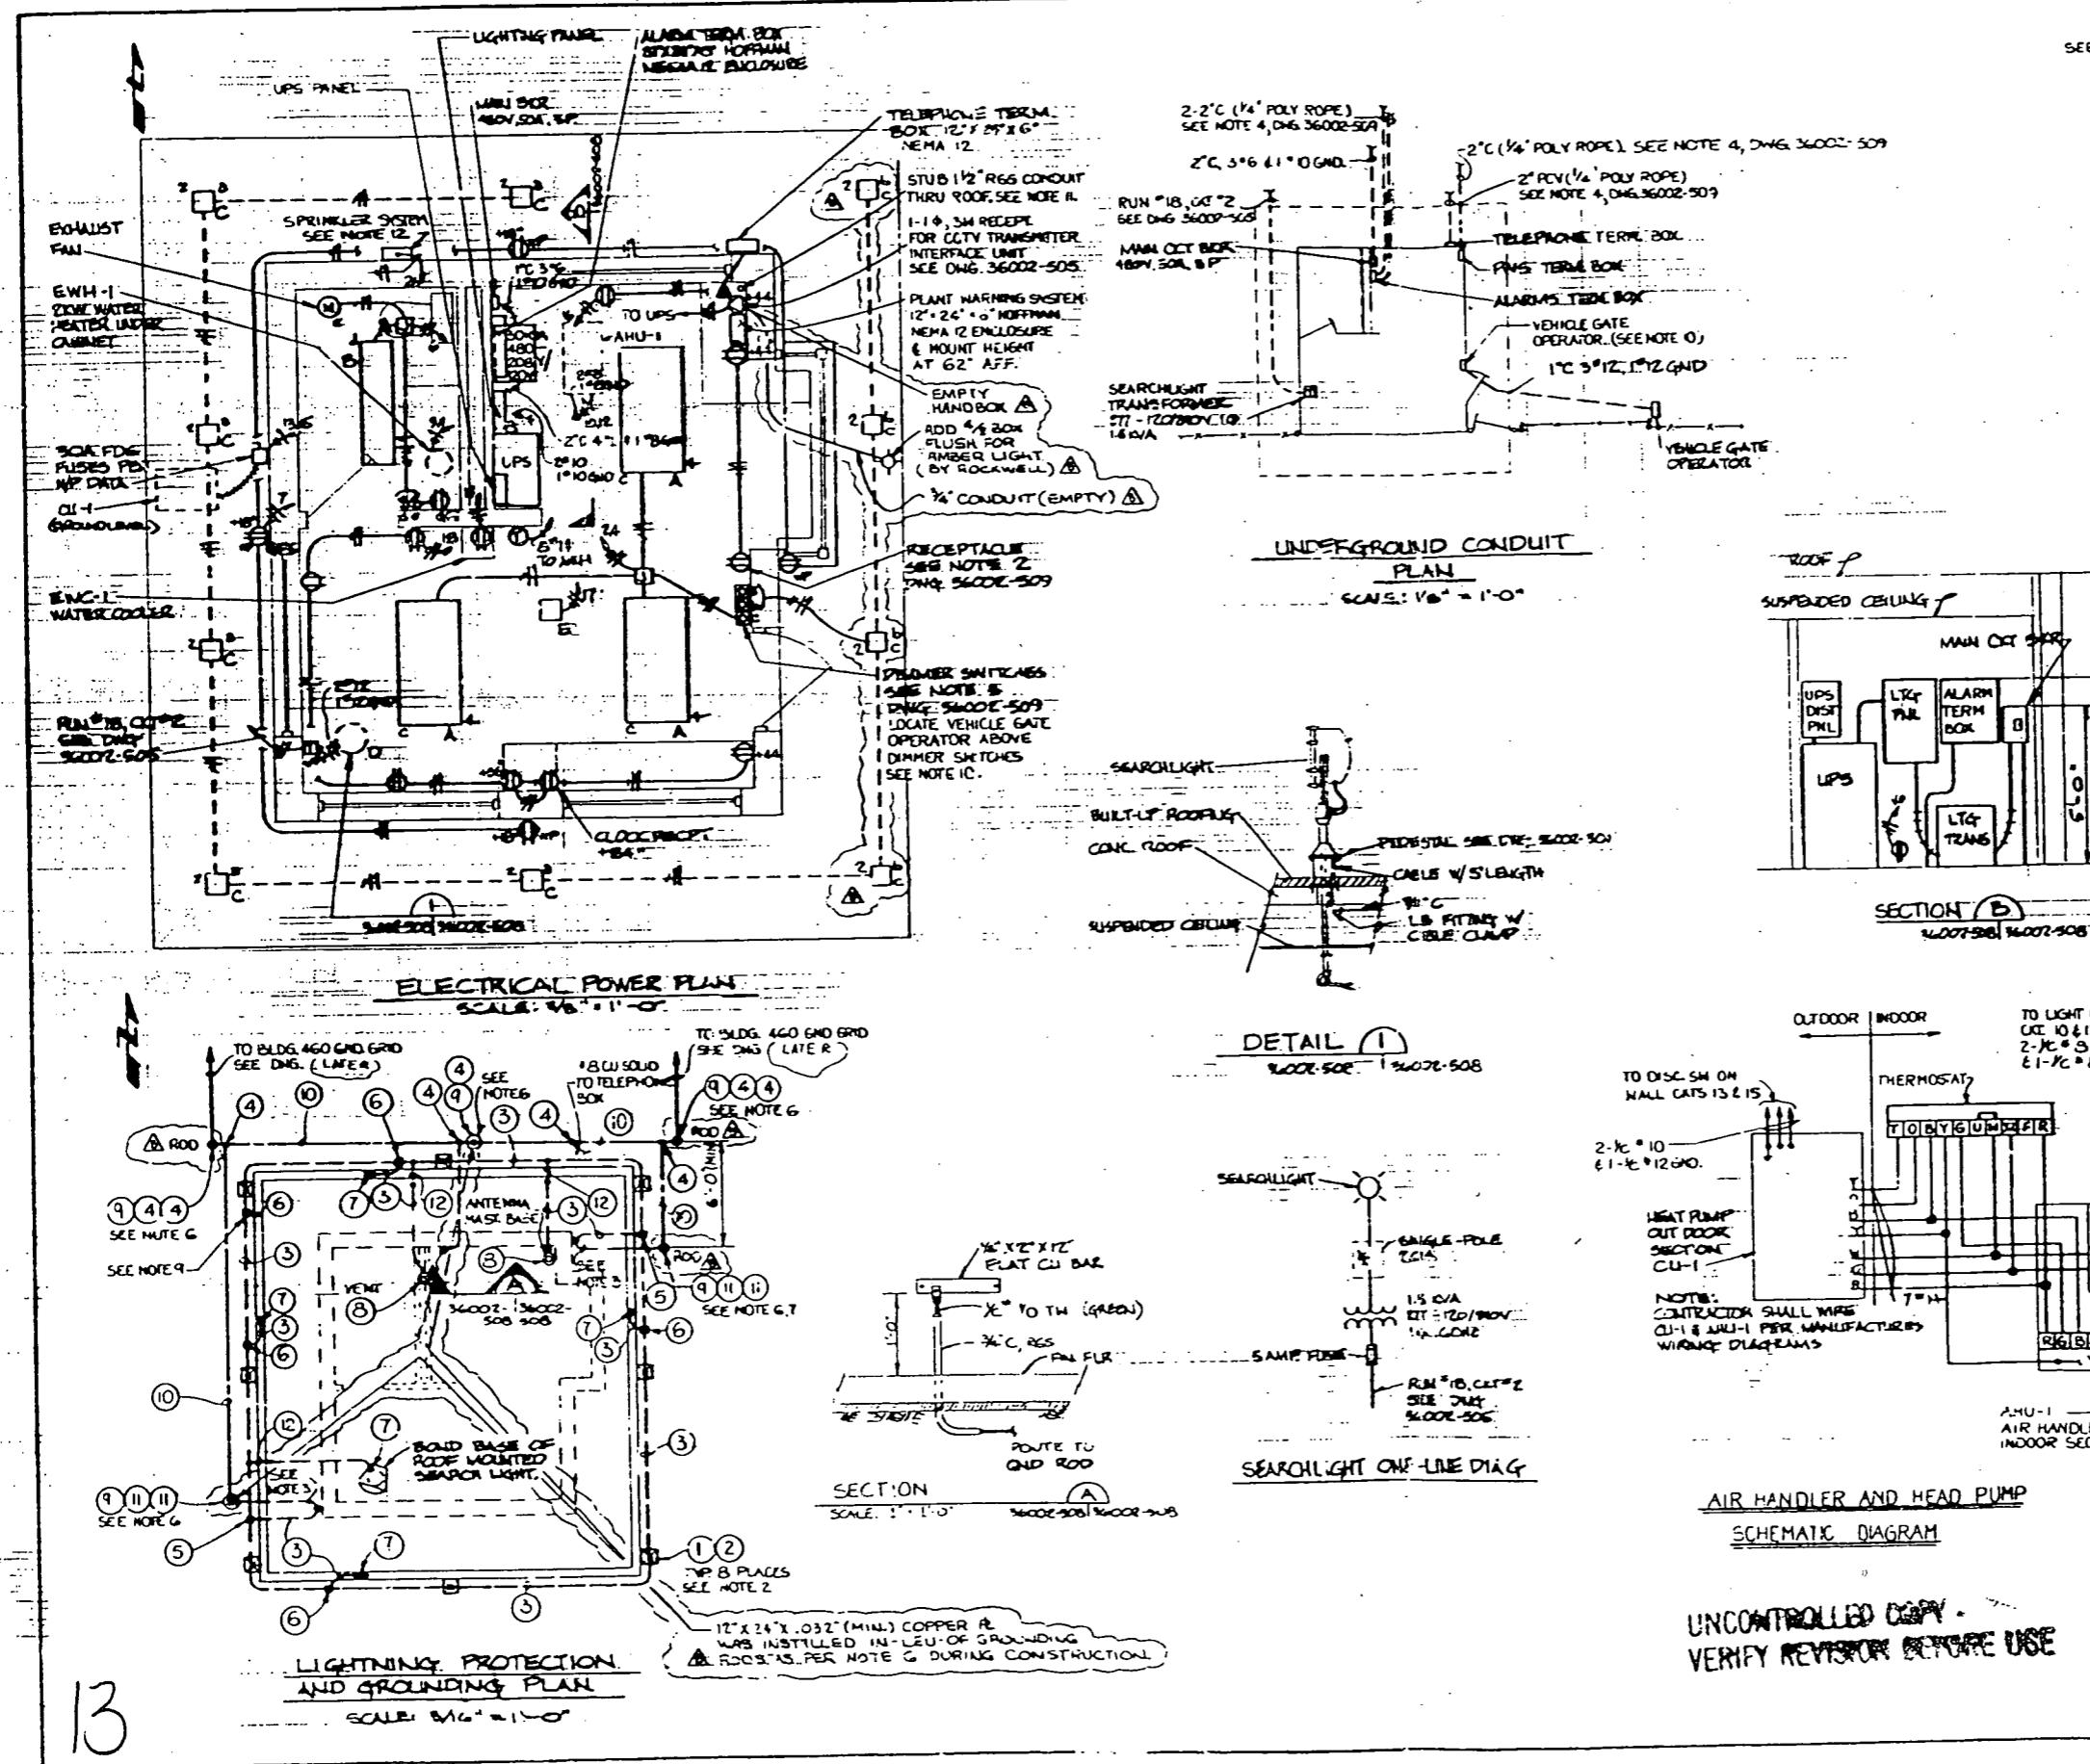


PART	ITEM	DESCRIPTION	MATERIAL
(1)	8	OFFSET WALL POINT BASE FOR 1/2-INCH COPPER POINT.	NO. 642
(2)	8	SOLID COPPER POINT 1/2-INCH DIAMETER BY 18-INCHES LONG	NO 22
(3)	200FT	COP-R CONDUCTOR, 17A.6 STRAND (MIN.), 137 LBS., 1000FT, ST400 CM (MIN.).	NO 6
(4)	8	COMPRESSION TYPE (ROSS CONNECTOR)	BURNON NO YSL
(5)	2	TEE CABLE SPlicer	NO 664
(6)	7	CABLE SPECER FOR PARALLEL SPLICING	NO 68A
(7)	5	BONDING LUG	NO 70X
(8)	2	PIPE BONDING STRAP	NO. 677-4
(9)	5	GROUND ROD, STANDARD TYPE COPPER-CLAD STEEL 3/4-INCH DIAMETER •10 FT. LONG.	NO 47-10
(10)	15FT	* 1/0 SOFT DRAWN BARE COPPER CABLE	_____
(11)	4	GROUND ROD CLAMP	THOMPSON NO 693
(12)	3	THRU-WALL CABLE CONNECTOR	NO 7440CT2

NOTES:

- 1.) ALL PART NO'S LISTED ABOVE FOR THE LIGHTNING PROTECTION SYSTEM ARE ROBBINS LIGHTNING PROTECTION CATALOGUE PART NUMBERS, EXCEPT AS NOTED.
  - 2.) INSTALL AIR TERMINAL AND BASE ON OUTSIDE FACE OF PARAPET. SUCH THAT TERMINAL EXTENDS 10° ABOVE TOP OF PARAPET.
  - 3.) ROUTE DOWN CONDUCTORS ON THE BUILDING EXTERIOR.
  - 4.) NO BEND OF A LIGHTNING PROTECTION CONDUCTOR SHALL FORM AN INCLUDED ANGLE OF LESS THAN 90° NOR HAVE A BEND RADIUS LESS THAN 8 INCHES.
  - 5.) PROPERLY ANCHOR ROOF PERIMETER CABLE AND DOWN CONDUCTORS ON 3 FT. CENTERS.
  - 6.) UNDERGROUND LIGHTNING PROTECTION SYSTEM CONNECTIONS SHALL BE BOLT TYPE. UNDERGROUND GROUNDING SYSTEM CONNECTIONS SHALL BE COMPRESSION TYPE. ABOVE GROUND LIGHTNING PROTECTION SYSTEM CONNECTIONS SHALL BE BOLT TYPE.
  - 7.) MAINTAIN 6'-0" MIN. BETWEEN ELECTRODES OF DIFFERENT SYSTEMS.
  - 8.) SEAL ALL PENETRATIONS THRU PARAPET WITH SILICON SEALANT.
  - 9.) CLAMP BUTT END OF PERIMETER CABLE.
  - 10.) MOUNT VEHICLE GATE OPERATOR ABOVE DIMMER SWITCHES AT 6'-0" AFF. INSTALL RADIO CONTROLLER PER MFR'S INSTRUCTIONS.
  - 11.) FOR DETAILS OF RADIO ANTENNA SUPPORT/RACEWAY SEE Dwg. 36002-301
  - 12.) LOCATE SPRINKLER SYSTEM CONTROL PANEL ON NORTHSIDE OF BLDG 4C1 IN A WEATHERPROOF (NEMA 3) ENCLOSURE.


25 BUILT - REVISIONS			4-3-BE1LC	530-EN	5234-2005
X	ORIGINAL ISSUE				
	DESCRIPTION		DATE	REF#	DOC
			U.S. DEPARTMENT OF ENERGY ROCKY FLATS AREA OFFICE GOLDEN, COLORADO		
					
			DIANE A. COLEMAN		
CONSOLIDATED NONNUCLEAR MANUFACTURING FACILITY EL DUE 000					
GUA DHOUSE BLDG. 461					
PCB	REMOVED	REMOVED	REMOVED	REMOVED	REMOVED
AD-NOTED	APPROVED	REMOVED	REMOVED	REMOVED	REMOVED
AD-NOTED	APPROVED	REMOVED	REMOVED	REMOVED	REMOVED
			D	36002-508	B 30-

UNCONTROLLED COPY -  
VERIFY REVISION BEFORE USE

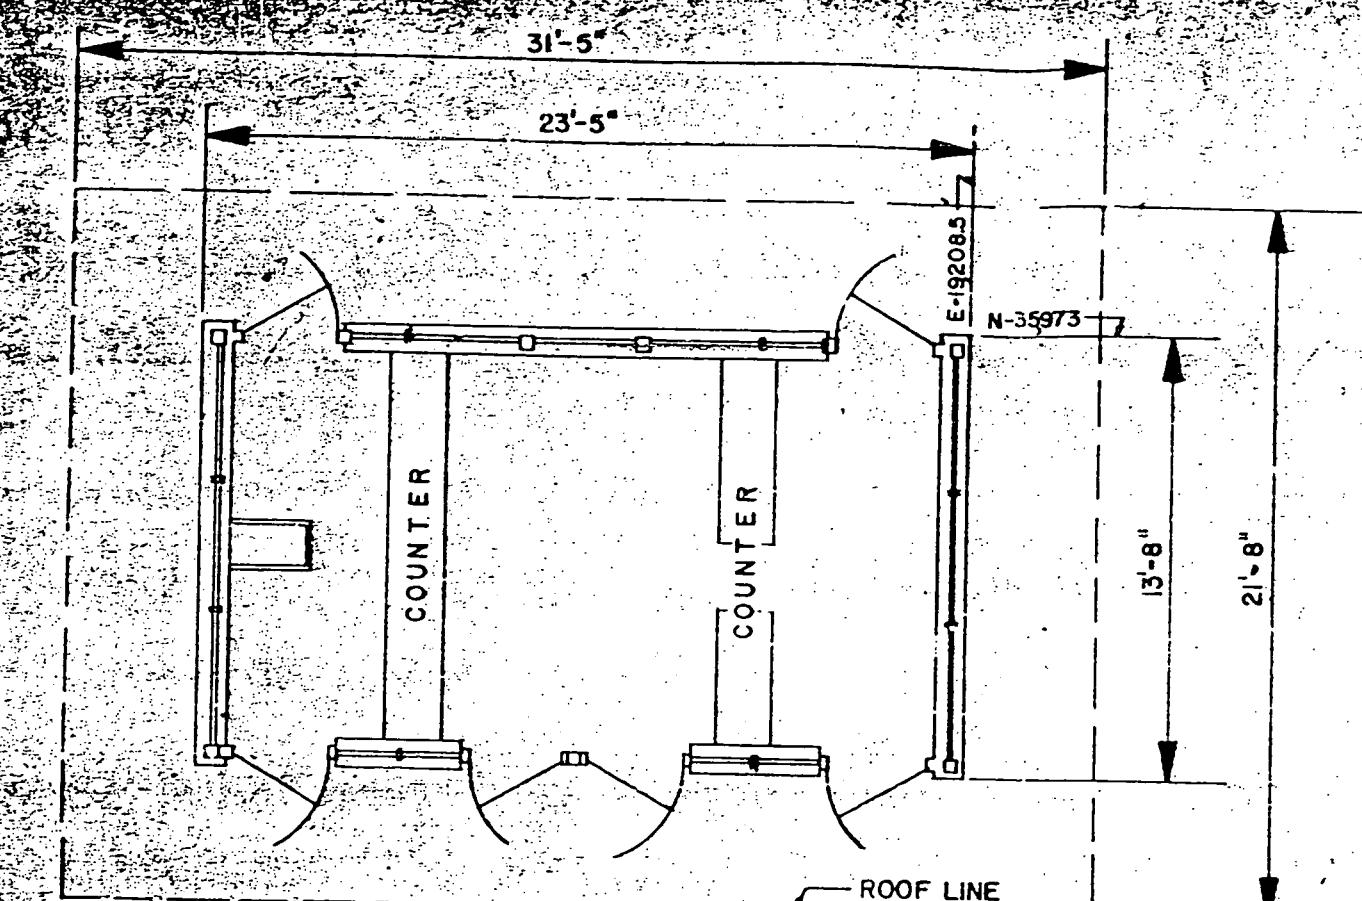

FLOOR PLAN

FINISHED FLOOR ELEVATION-6024'-2"

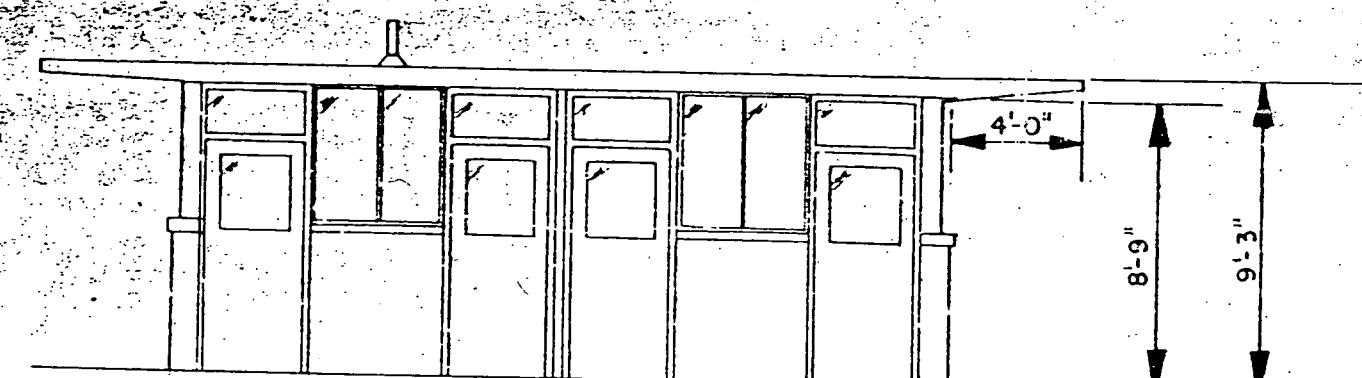


SOUTH ELEVATION

UNCONTROLLED COPY  
VERIFY REVERSE BEFORE USE

14

GRAPHIC SCALE

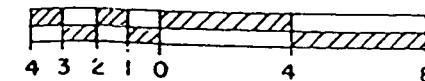


REFERENCE DRAWINGS

ITEM	DWG. NO.	TITLE	JOB
1.	RF-46-IC	BLDG-46,73,82	ORIG. CONST. "AUSTIN"


BUILDING AREA

320 SQUARE FEET

ORIGINAL ISSUE			7-15-69	ACC.	EX-470	DATE	BY	APPRO	CLASSIFIED	JOB. NO.
ISSUE	DESCRIPTION	1-10								
TOLENCES	FRAC-	3'	DATE	U. S. ATOMIC ENERGY COMMISSION						
ANGLE	DESIGNED			ROCKY FLATS AREA OFFICE GOLDEN, COLORADO						
DEC	DRAWN	RJ	7-6-69	THE DOW CHEMICAL COMPANY						
UNITS NOTED	CHECKED	GRISSMAN	7-6-69	AEC CONTRACT AT 125-11106						
INCH-FAISE	APPROVED	REISNER	7-6-69	ROCKY FLATS DIVISION GOLDEN, COLORADO						
REMOVED BURRS	REVIEWED	REILLY	7-6-69	Building 446						
AND SHARP EDGES	NEAT ASSEMBLY	REILLY	7-6-69	FLOOR PLAN & ELEVATION						
MEAT ASSEMBLY	SUBMITTED			SIZE	DRAWING NUMBER	ISSUE	SHEET			

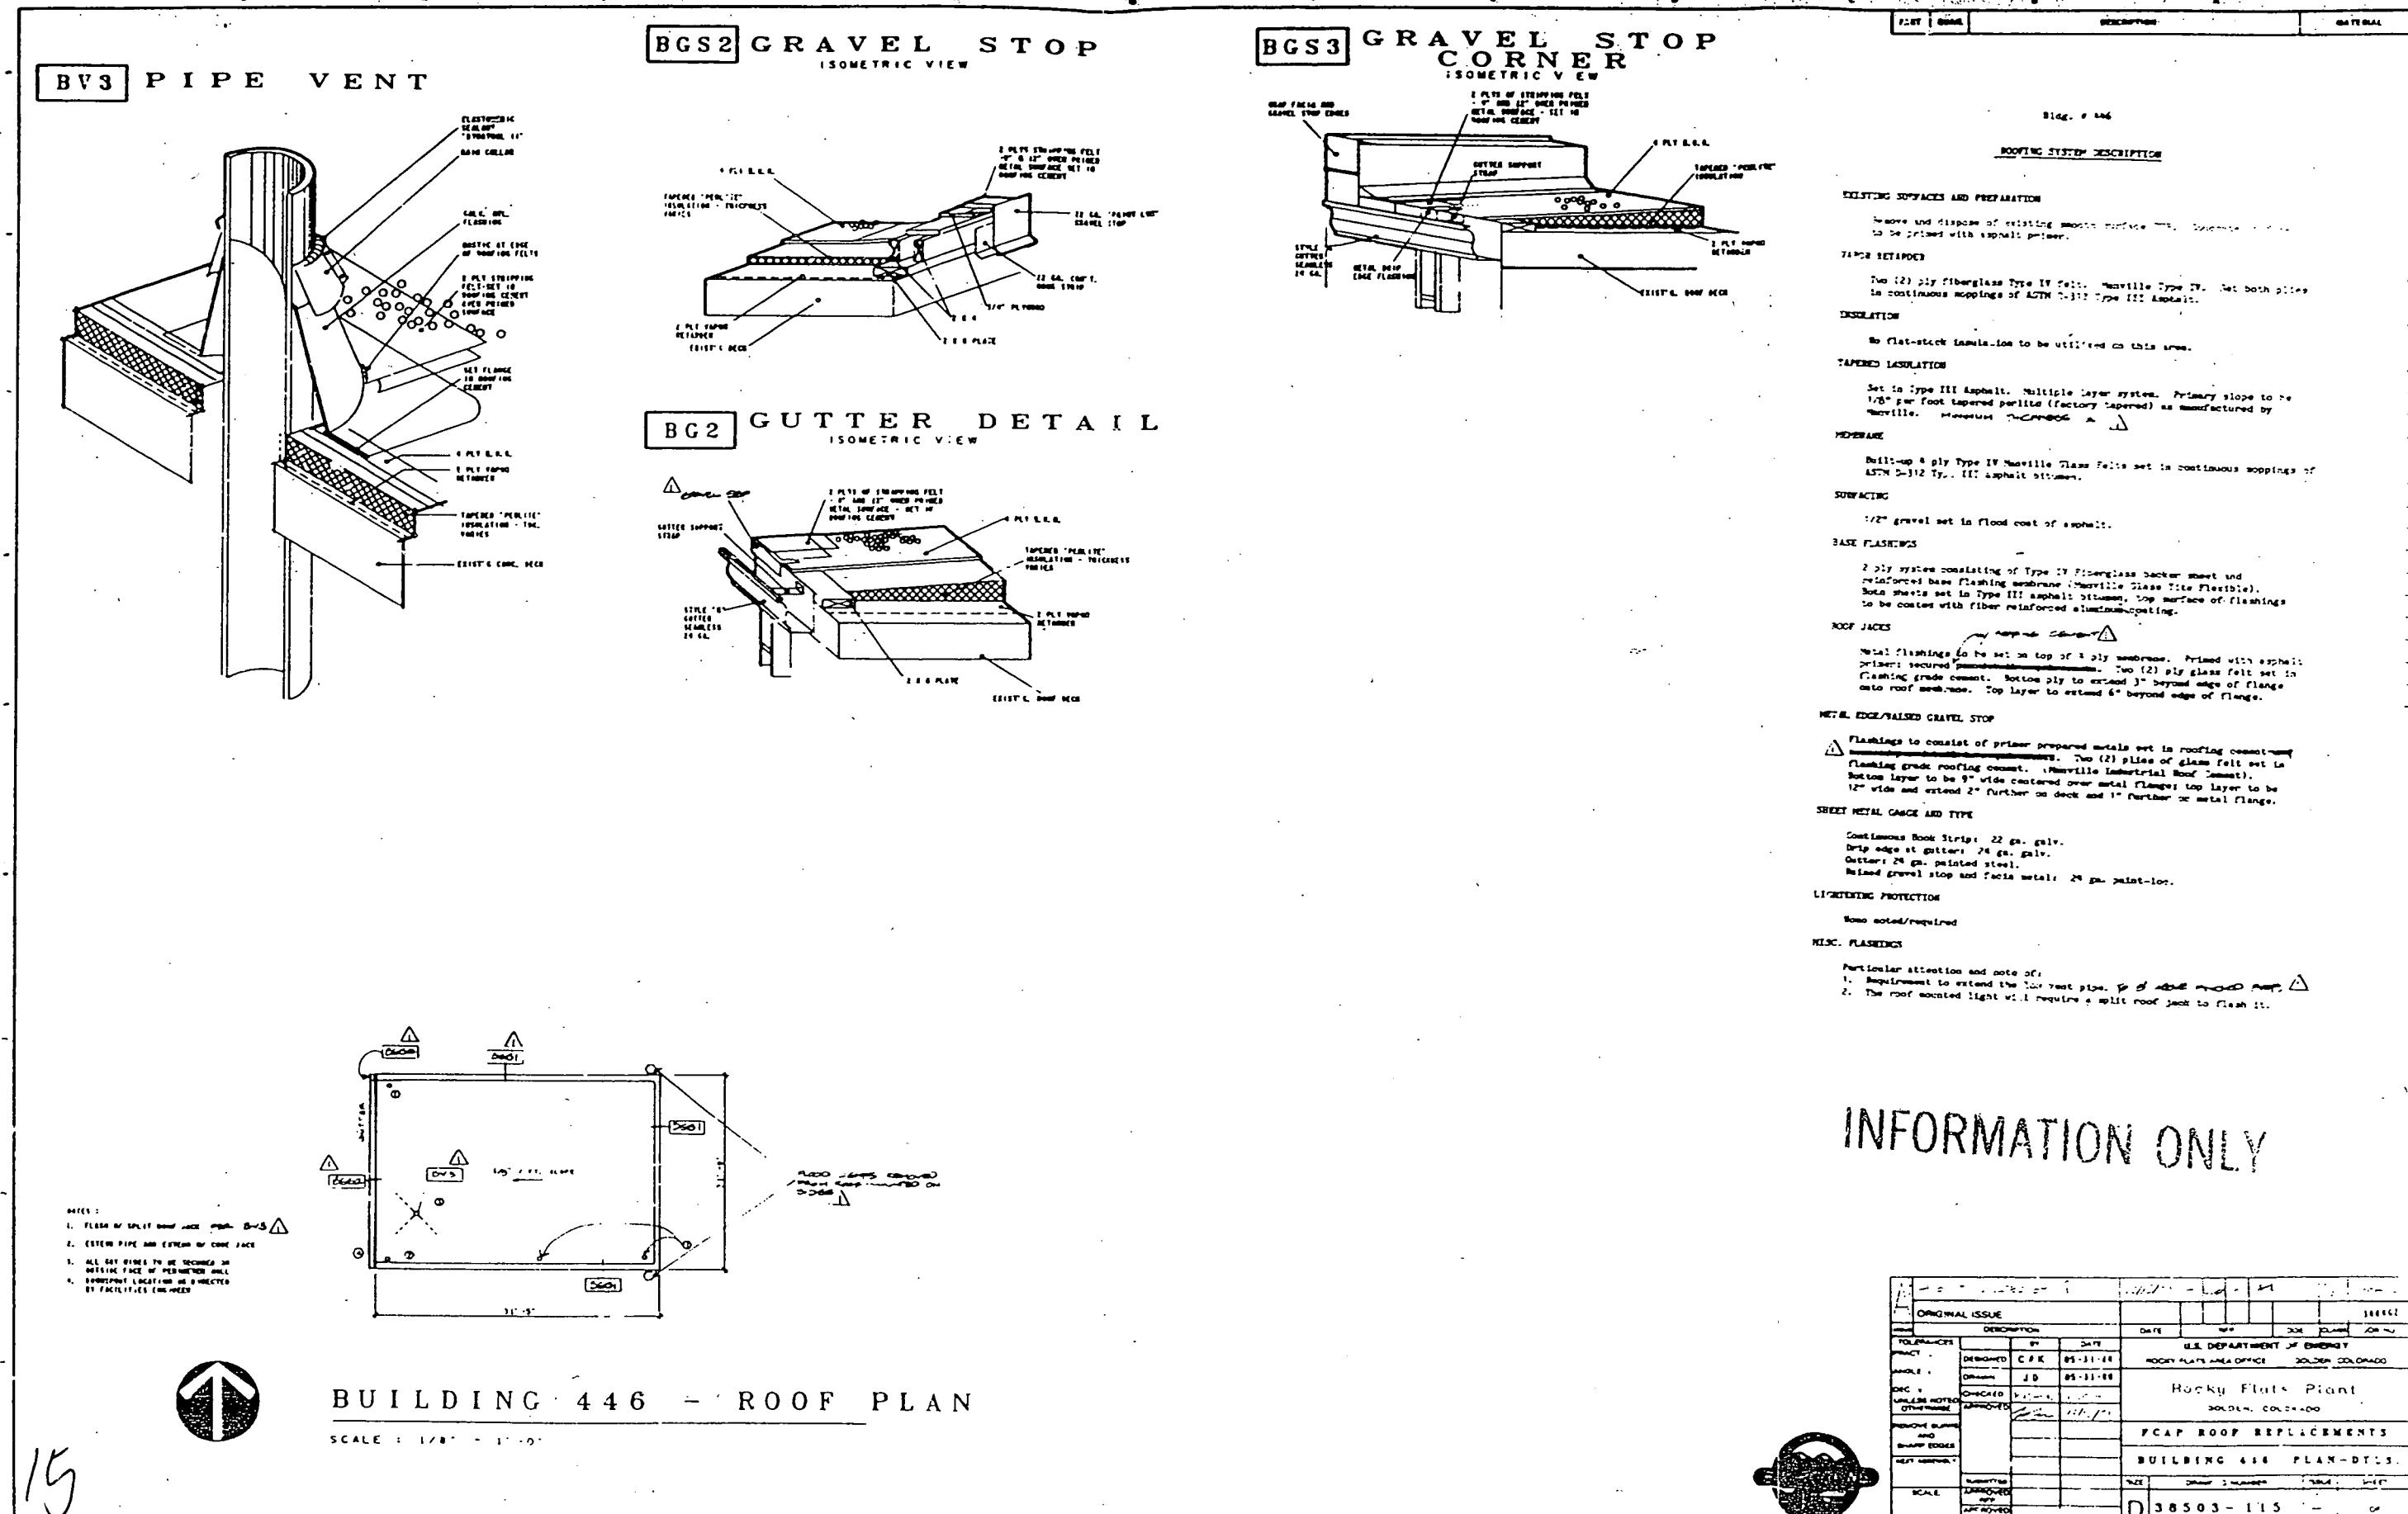


15

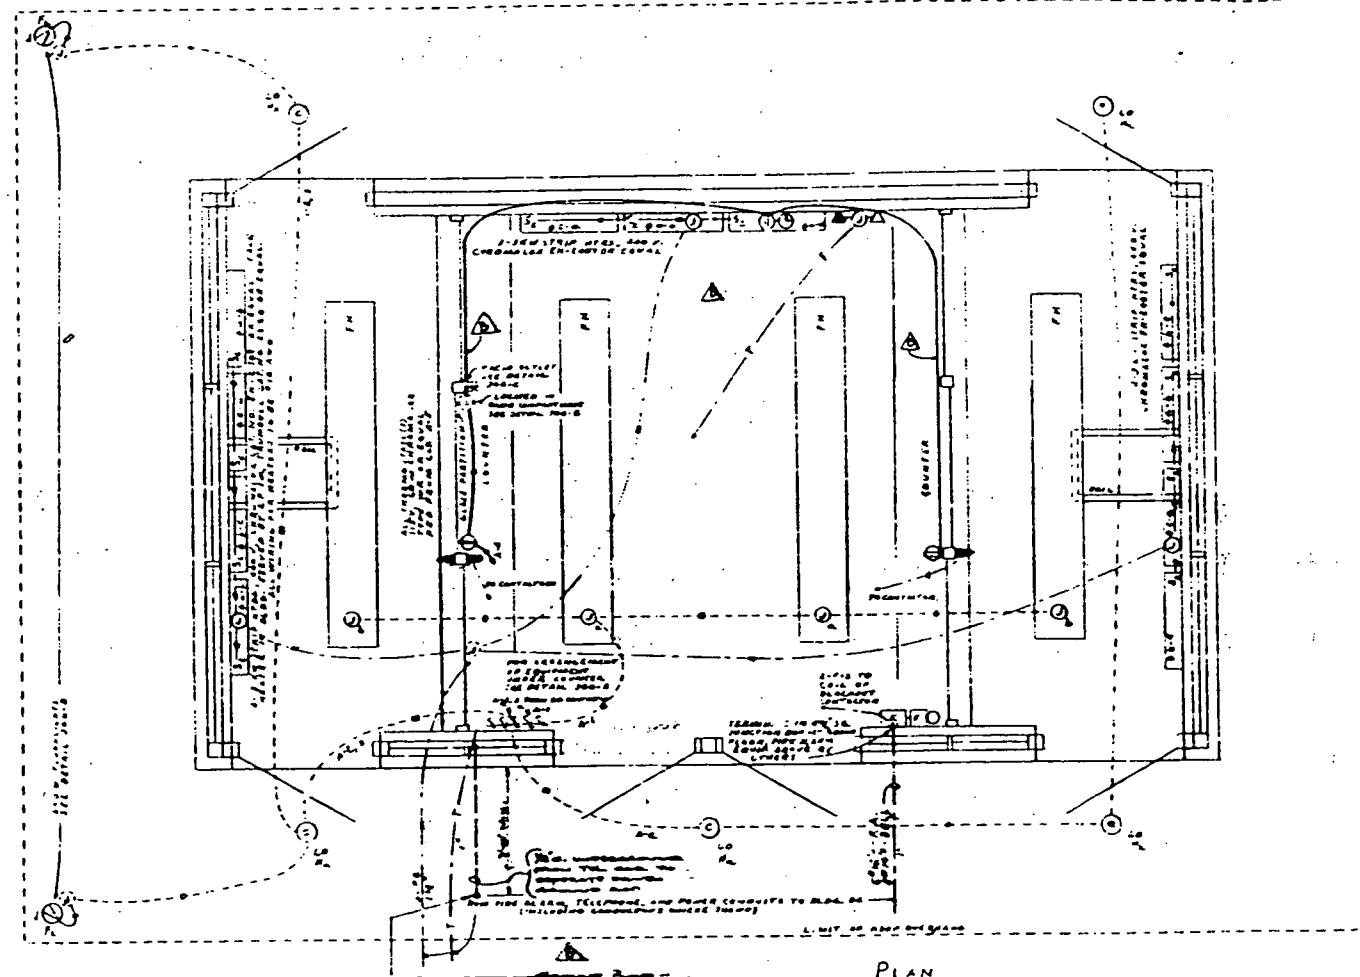


**DETAIL 300-A ARRANGEMENT OF EQUIPMENT**  
SCALE: 1" = 5'-0"


16/16

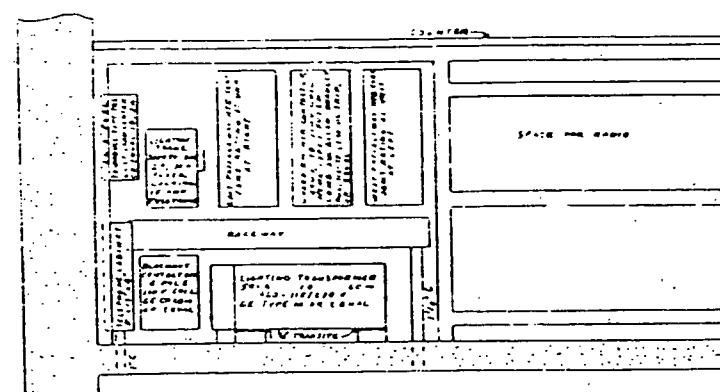

DETAIL 300-B. FLOODLIGHTS ON ROOF  
NOT TO SCALE

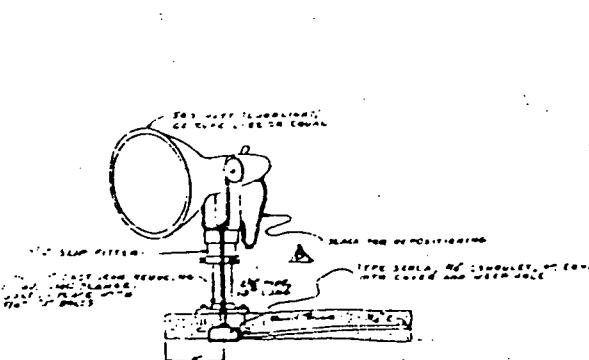


DETAIL 300-C ANTENNA MAST INSTALLATION  
NOT TO SCALE

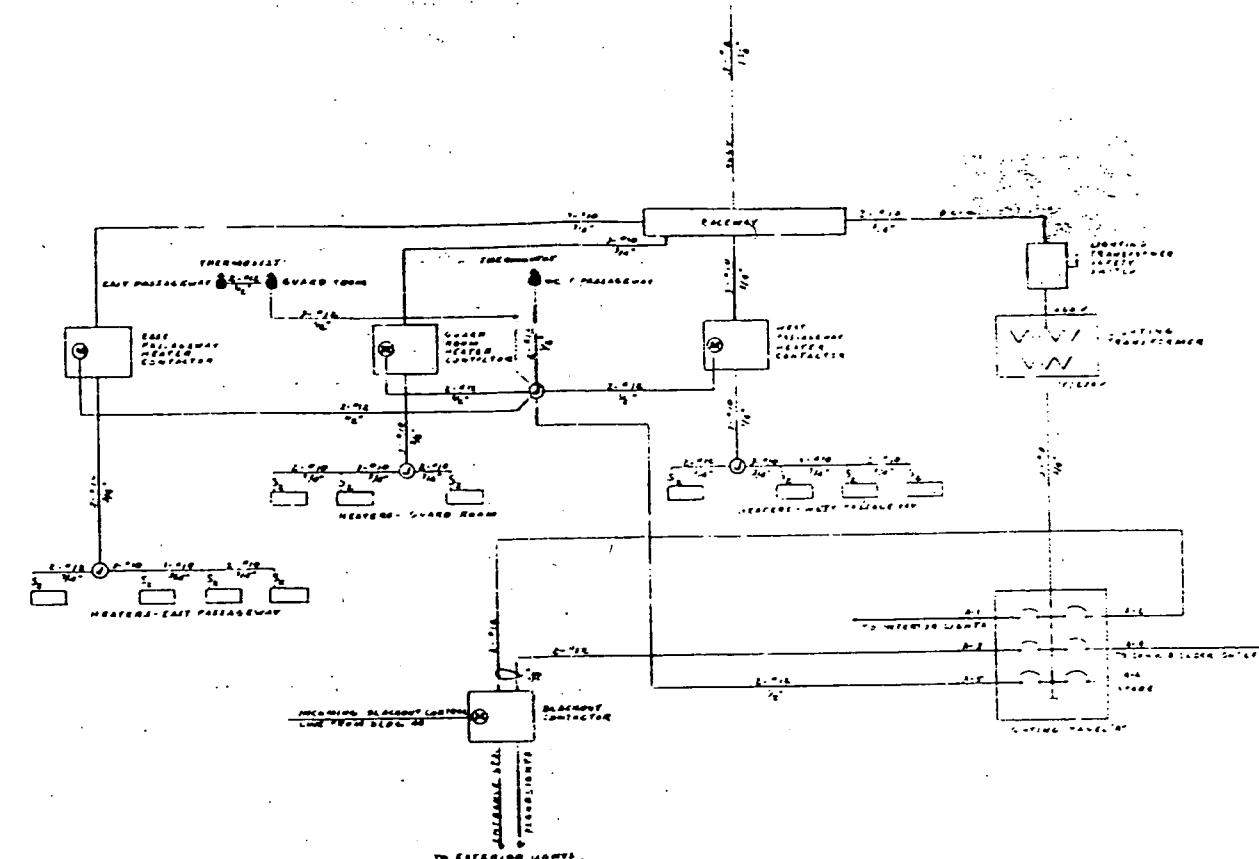

## ONE LINE DIAGRAM - POWER AND LIGHTING

REF-C-300 SYMBOLS  
REF-O-301 FIXTURE SCHEDULE

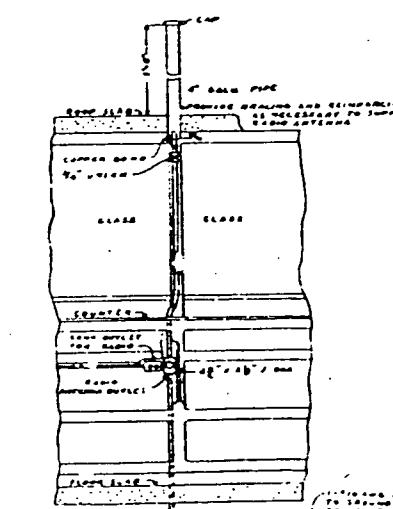

## NOTES

- 1 ALL CONDUIT IN SLAB IF UNLESS OTHERWISE IS NOTED
  - 2 MOUNT ALL SWITCHES AT 4 FT. ON. 12 FT. BELOW GROUNDS
  - 3 ALL WIRING NOT OTHERWISE INDICATED 17/2 14/2
  - 4 ALL LIGHTING FIXTURES LIST INCLUDING FLOOD SPOTLIGHTS ARE TO BE INCANDESCENT

THE AUSTIN COMPANY ENGINEERS AND BUILDERS CLEVELAND												U. S. ATOMIC ENERGY COMMISSION SANTA FE OPERATIONS OFFICE LOS ALAMOS, NEW MEXICO		BUILDING NO. 46 SAFE LIGHTING, TELEPHONE & ALARM SYSTEMS	
SUBMITTED BY THE AUSTIN COMPANY DATE 5-5-52 TO THE ROCKY FLATS PLANT APPROVAL DATE 4-11-52 BY THE ROCKY FLATS PLANT APPROVAL DATE 4-11-52												APPROVED BY THE U. S. ATOMIC ENERGY COMMISSION DATE 5-5-52 DEPARTMENT OF ENERGY APPROVAL DATE 5-5-52		PROJECT NO. RFP-42-100 C	
CONTRACT NO. 1470 (42-11-1104) W. O. S. 8001															
APPROVED FOR FAC 213 AS SHOWN NO CHANGES MADE APPROVED FOR FINAL APPROVAL															